

KEY NOTES - DETAIL 1

- (1) REMOVE (E) FIRE SPRINKLER WATERFLOW SWITCH FOR BUILDING 45.
- 2 REMOVE (E) FIRE SPRINKLER WATERFLOW SWITCH AND VALVE POSITION SUPERVISORY SWITCH FOR BUILDING 43. RETAIN THE WATERFLOW SWITCH AND VALVE SUPERVISORY SWITCH FOR REINSTALLATION AT A NEW LOCATION.
- 3 REMOVE (E) MANUAL FIRE ALARM CALL BOX ON THE EXTERIOR OF BUILDING 45. RETAIN THE MANUAL FIRE ALARM CALL BOX AT A NEW LOCATION.
- REMOVE (E) FIRE ALARM CONDUIT AND CIRCUITS ROUTED THROUGH AND ATTACHED TO BUILDING 45. RETAIN THE FIRE ALARM CIRCUITS FOR REINSTALLATION AT A NEW LOCATION.

1 FIRE ALARM - DEMOLITION PLAN FA1.0 SCALE: 1/8"=1'-0"

(E) BLDG 48

KEY NOTES - DETAIL 2

- 1 INSTALL TEMPORARY RACEWAY UTILIZING THE EXISTING CIRCUITS REMOVED IN KEY NOTE #4, DETAIL 1 TO SERVE THE FIRE SPRINKLER WATERFLOW SWITCH, VALVE POSITION SUPERVISORY SWITCH AND MANUAL FIRE ALARM CALL BOXES FOR BUILDING 63. INSTALL RACEWAY ALONG THE EXISTING TRENCH NORTH OF BUILDING 45.
- 2 INSTALL TEMPORARY FIRE SPRINKLER WATERFLOW SWITCH AND VALVE POSITION SUPERVISORY SWITCH FOR BUILDING 43 UTILIZING THE WATERFLOW SWITCH AND VALVE SUPERVISORY SWITCH REMOVED IN KEY NOTE #2, DETAIL 1.
- (3) INSTALL MANUAL FIRE ALARM CALL BOX ON THE EXTERIOR OF BUILDING 45 UTILIZING THE MANUAL FIRE ALARM CALL BOX REMOVED IN KEY NOTE #3, DETAIL 1.
- REMOVE (E) FIRE ALARM CONDUIT AND CIRCUITS ROUTED THROUGH AND ATTACHED TO BUILDING 45.
 RETAIN THE FIRE ALARM CIRCUITS FOR REINSTALLATION AT A NEW LOCATION.

2 FIRE ALARM - INTERIM PROTECTION PLAN FA1.0 SCALE: 1/8"=1'-0"




AS BUILT


CONSULTING FIRM

1-3-1

(E) BLDG 43



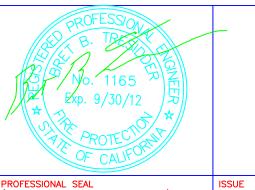

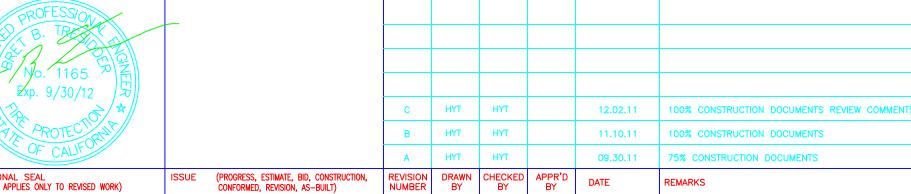

1-4-2 1-4-3

1-4-1

BUILDING 45 FIRE STATION REPLACEMENT

FIRE ALARM - DEMOLITION PLAN

UNIVERSITY OF CALIFORNIA LAWRENCE BERKELEY NATIONAL LABORATORY FACILITIES DIVISION

	DRAWN BY HYT	DATE 12.02.11
	CHECKED BY HYT	12.02.11
	APPROVED BY	
	CAD FILE PATH	
	SCALE AS NOTED	
	DRAWING NO.	SHEET
	4B45E026	FA1.0
J	PROJECT NO.	38 OF 43